


8 Flags - As Built Space Plan for Suites 13 & 14

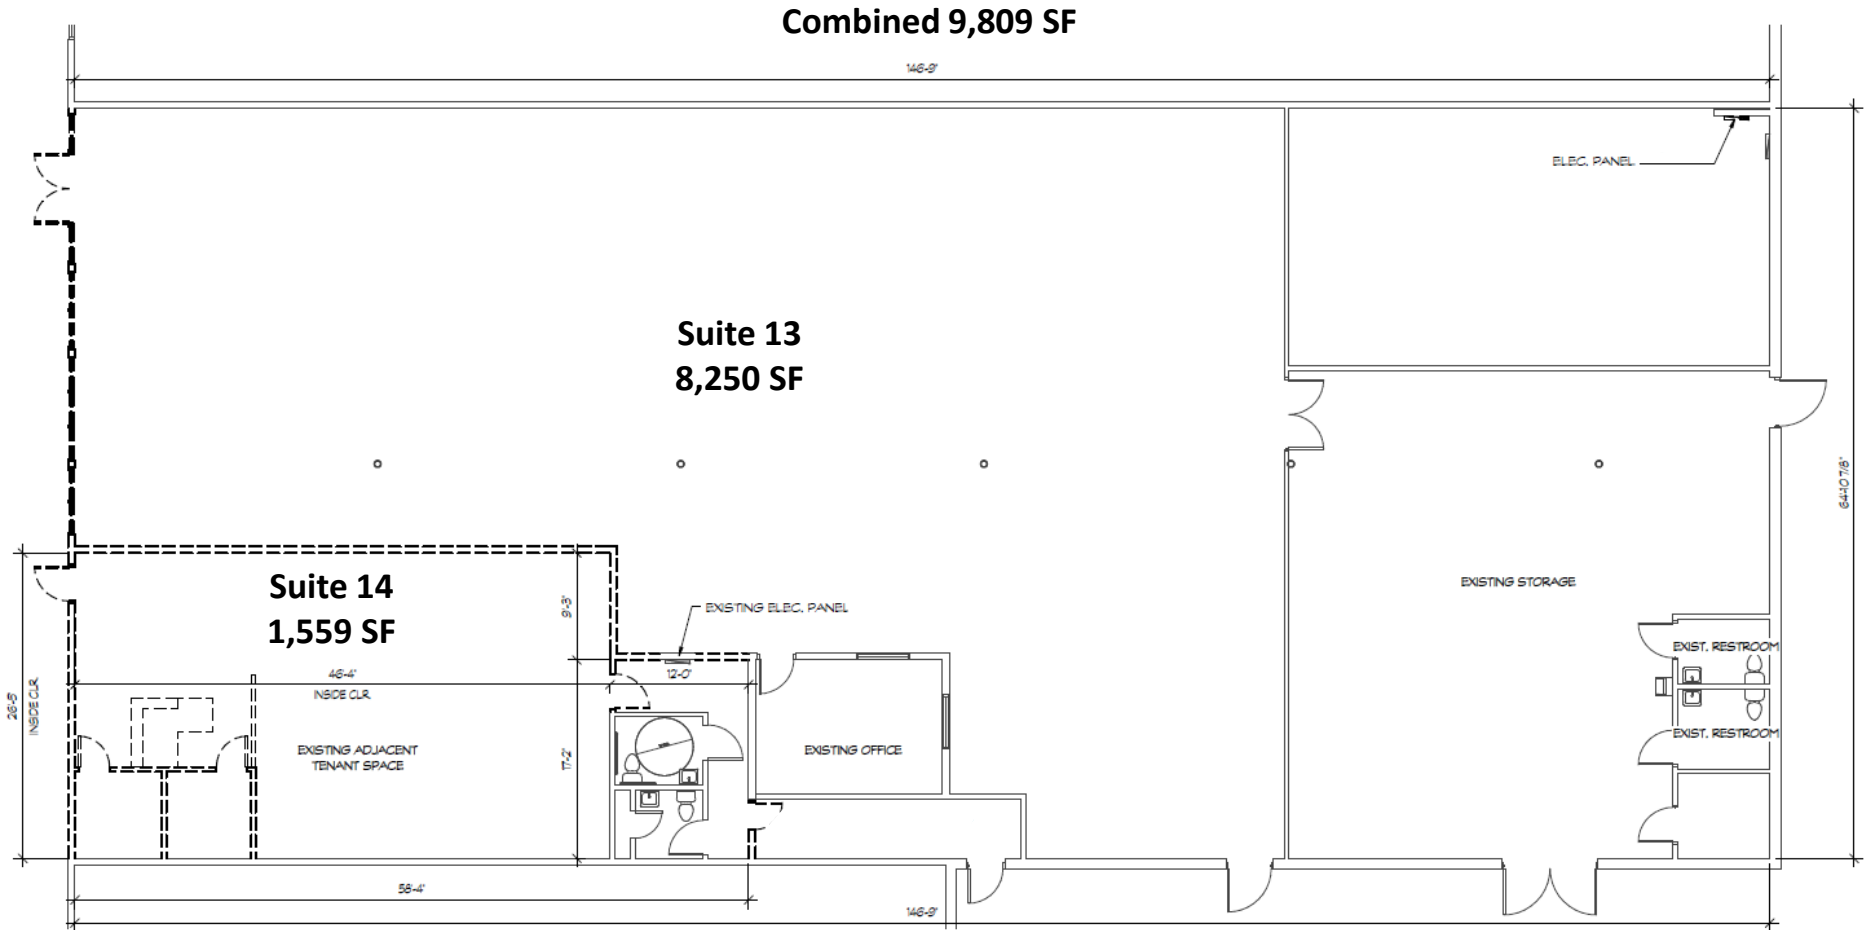

1 AS-BUILT
A01 SCALE: 1/8" = 1'-0"

Thomas W. Wheeler, Jr.
Associate Broker
Mobile: 404.285.3257
tomsipad@gmail.com

BRAND Real Estate Services
1960 Satellite Boulevard, Suite 1300
Duluth, Georgia 30097
770.476.4801 BrandProperties.com