


8 Flags – As Built Space Plan for Suites 13 & 14

Combined Suites are 9,809 SF

146' 9"

Suite 13
8,250 SF

Suite 14
1,559 SF

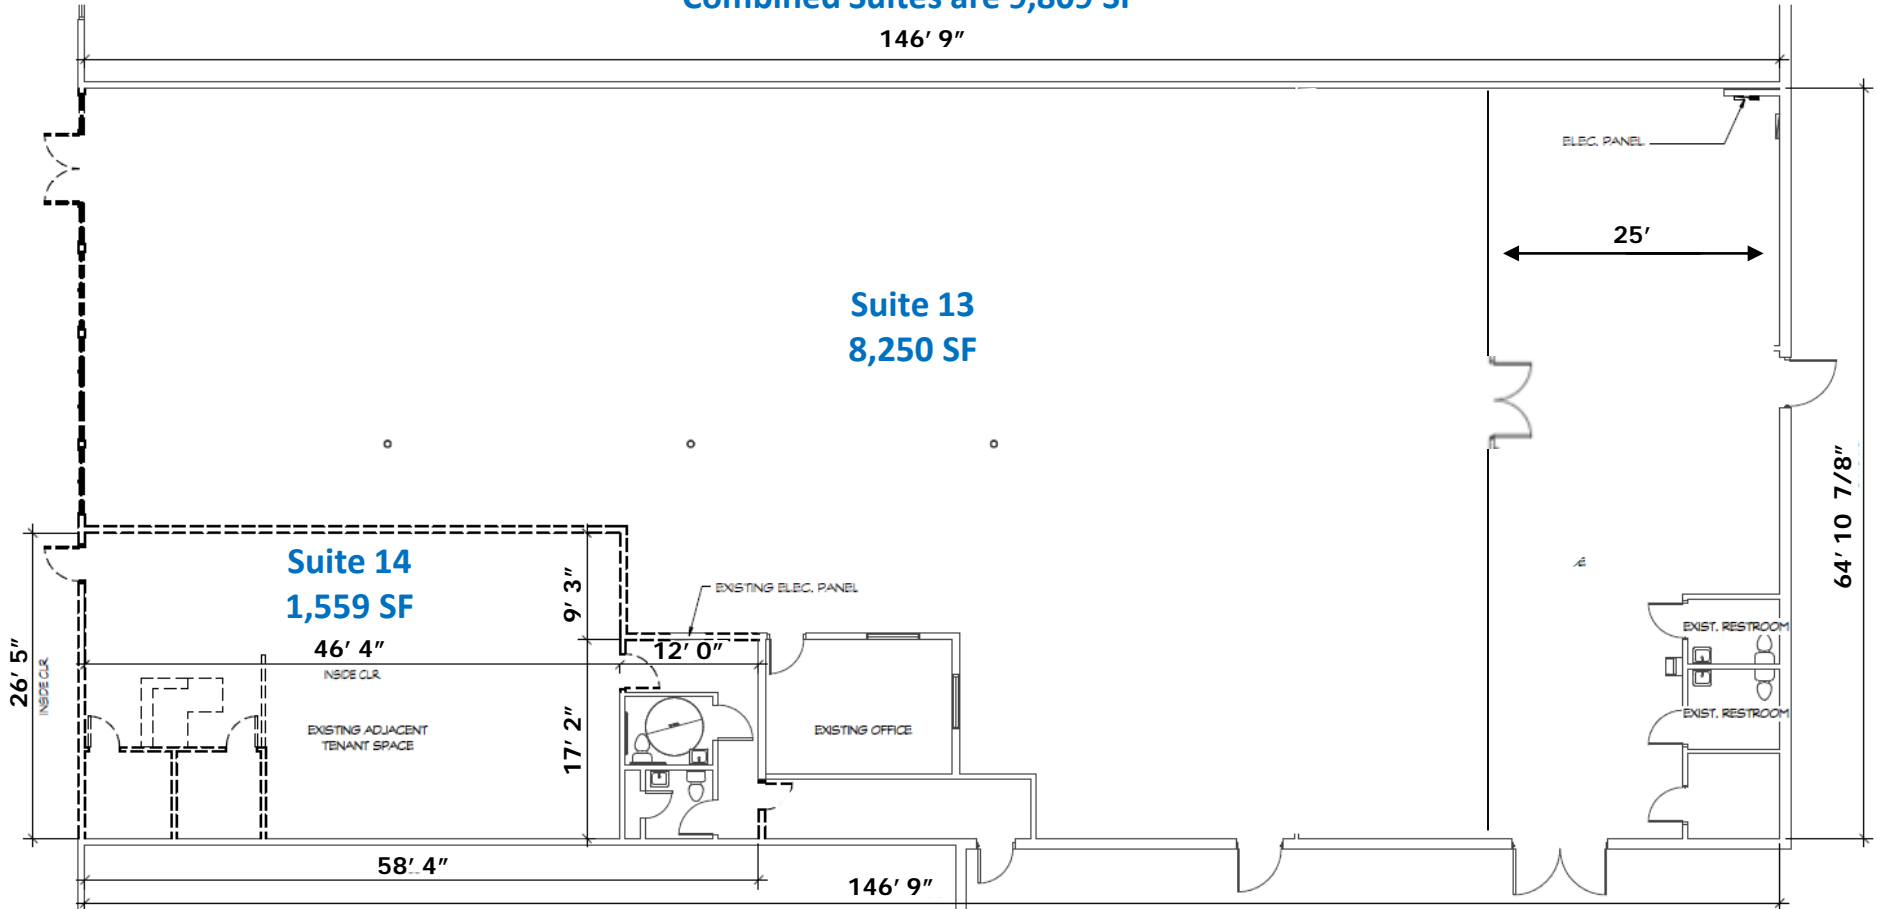

1 AS-BUILT
A01 SCALE: 1/8" = 1'-0"

Thomas W. Wheeler, Jr.
Associate Broker
Mobile: 404.285.3257
tomsipad@gmail.com

BRAND Real Estate Services
1960 Satellite Boulevard, Suite 1300
Duluth, Georgia 30097
770.476.4801 BrandProperties.com