




4961 Lower Roswell Road
Marietta, Georgia 30068

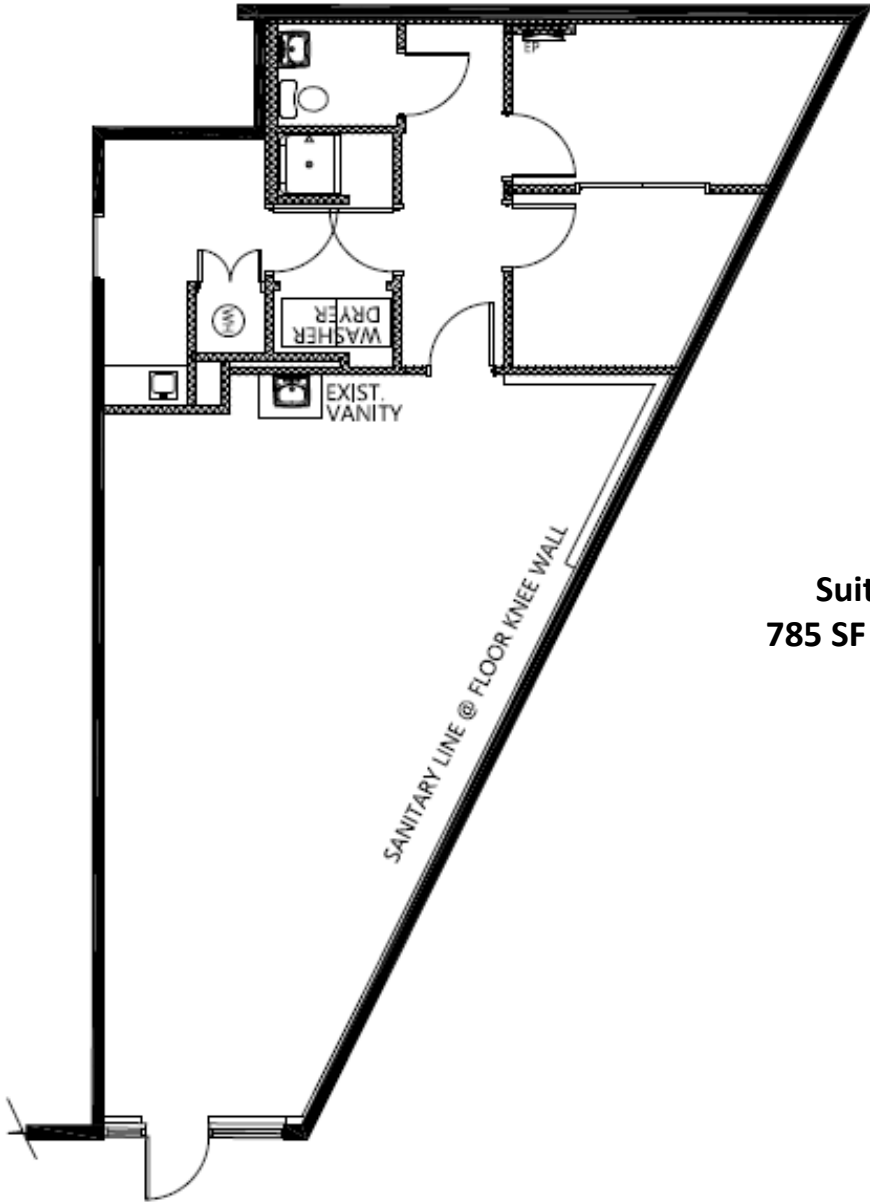

Suite 107
785 SF Available

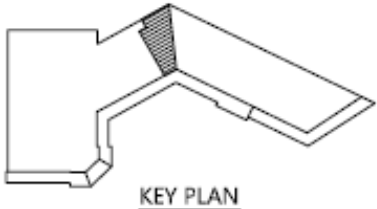

Suite 107 As-built

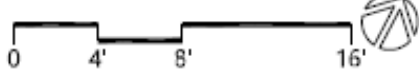

TOTAL - 785 RSF
03/29/2022