


4961 Lower Roswell Road
Marietta, Georgia 30068

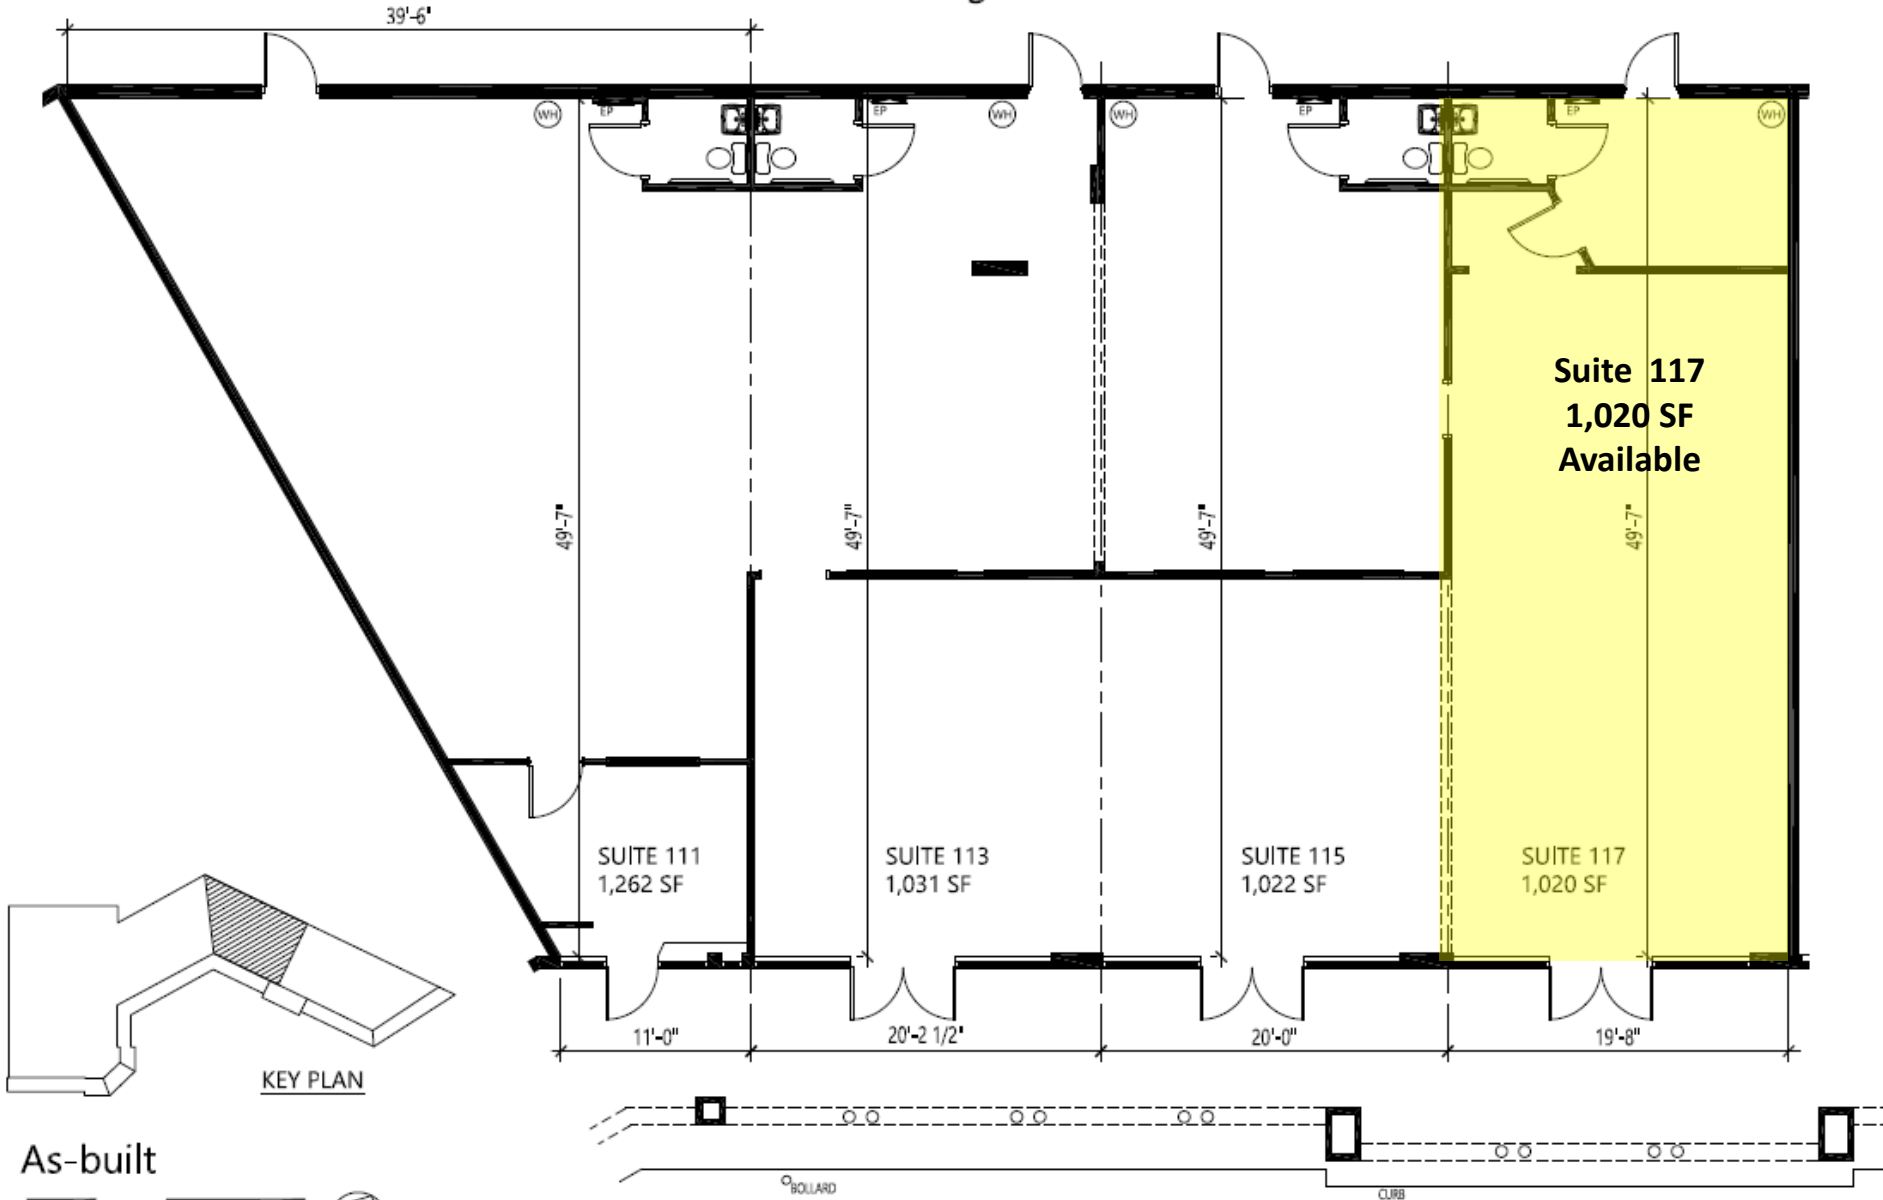

Suite 117
1,020 SF
Available

SUITE 111
1,262 SF


SUITE 113
1,031 SF

SUITE 115
1,022 SF

SUITE 117
1,020 SF

KEY PLAN

As-built

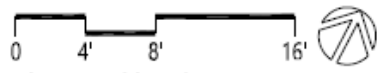

TOTAL - 4,335 RSF
1/27/2021