

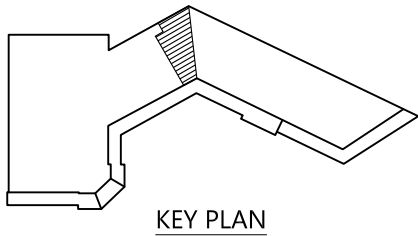


4961 Lower Roswell Road  
Marietta, Georgia 30068

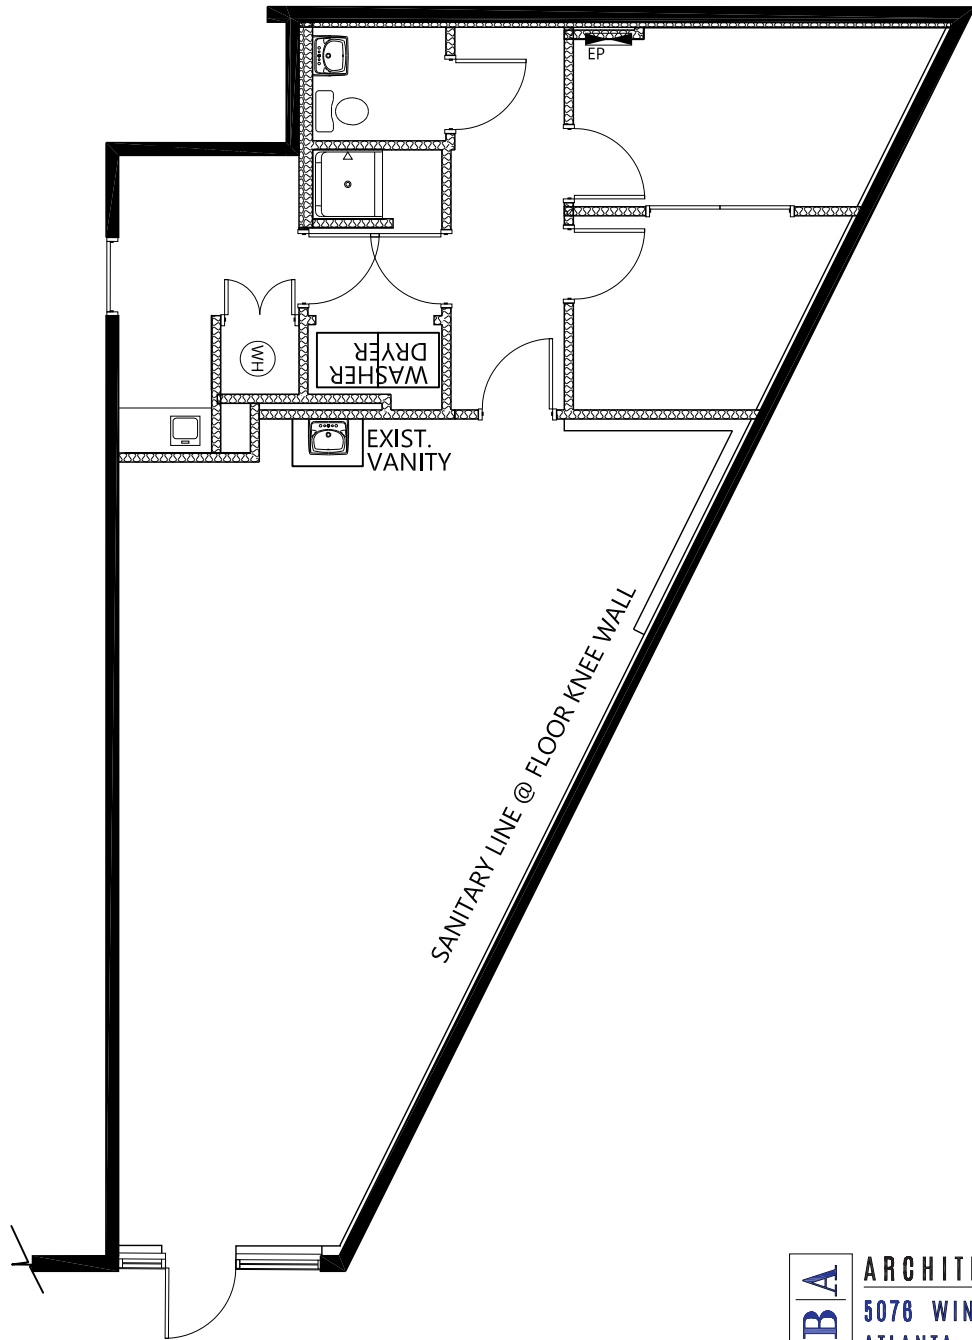

Suite 107 As-built

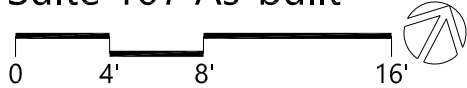

TOTAL - 785 RSF  
03/29/2022

**LBA** ARCHITECTURE + INTERIOR DESIGN  
5076 WINTERS CHAPEL RD, SUITE 100  
ATLANTA, GA 30380  
(o) 770.398.3207