


4961 Lower Roswell Road
Marietta, Georgia 30068

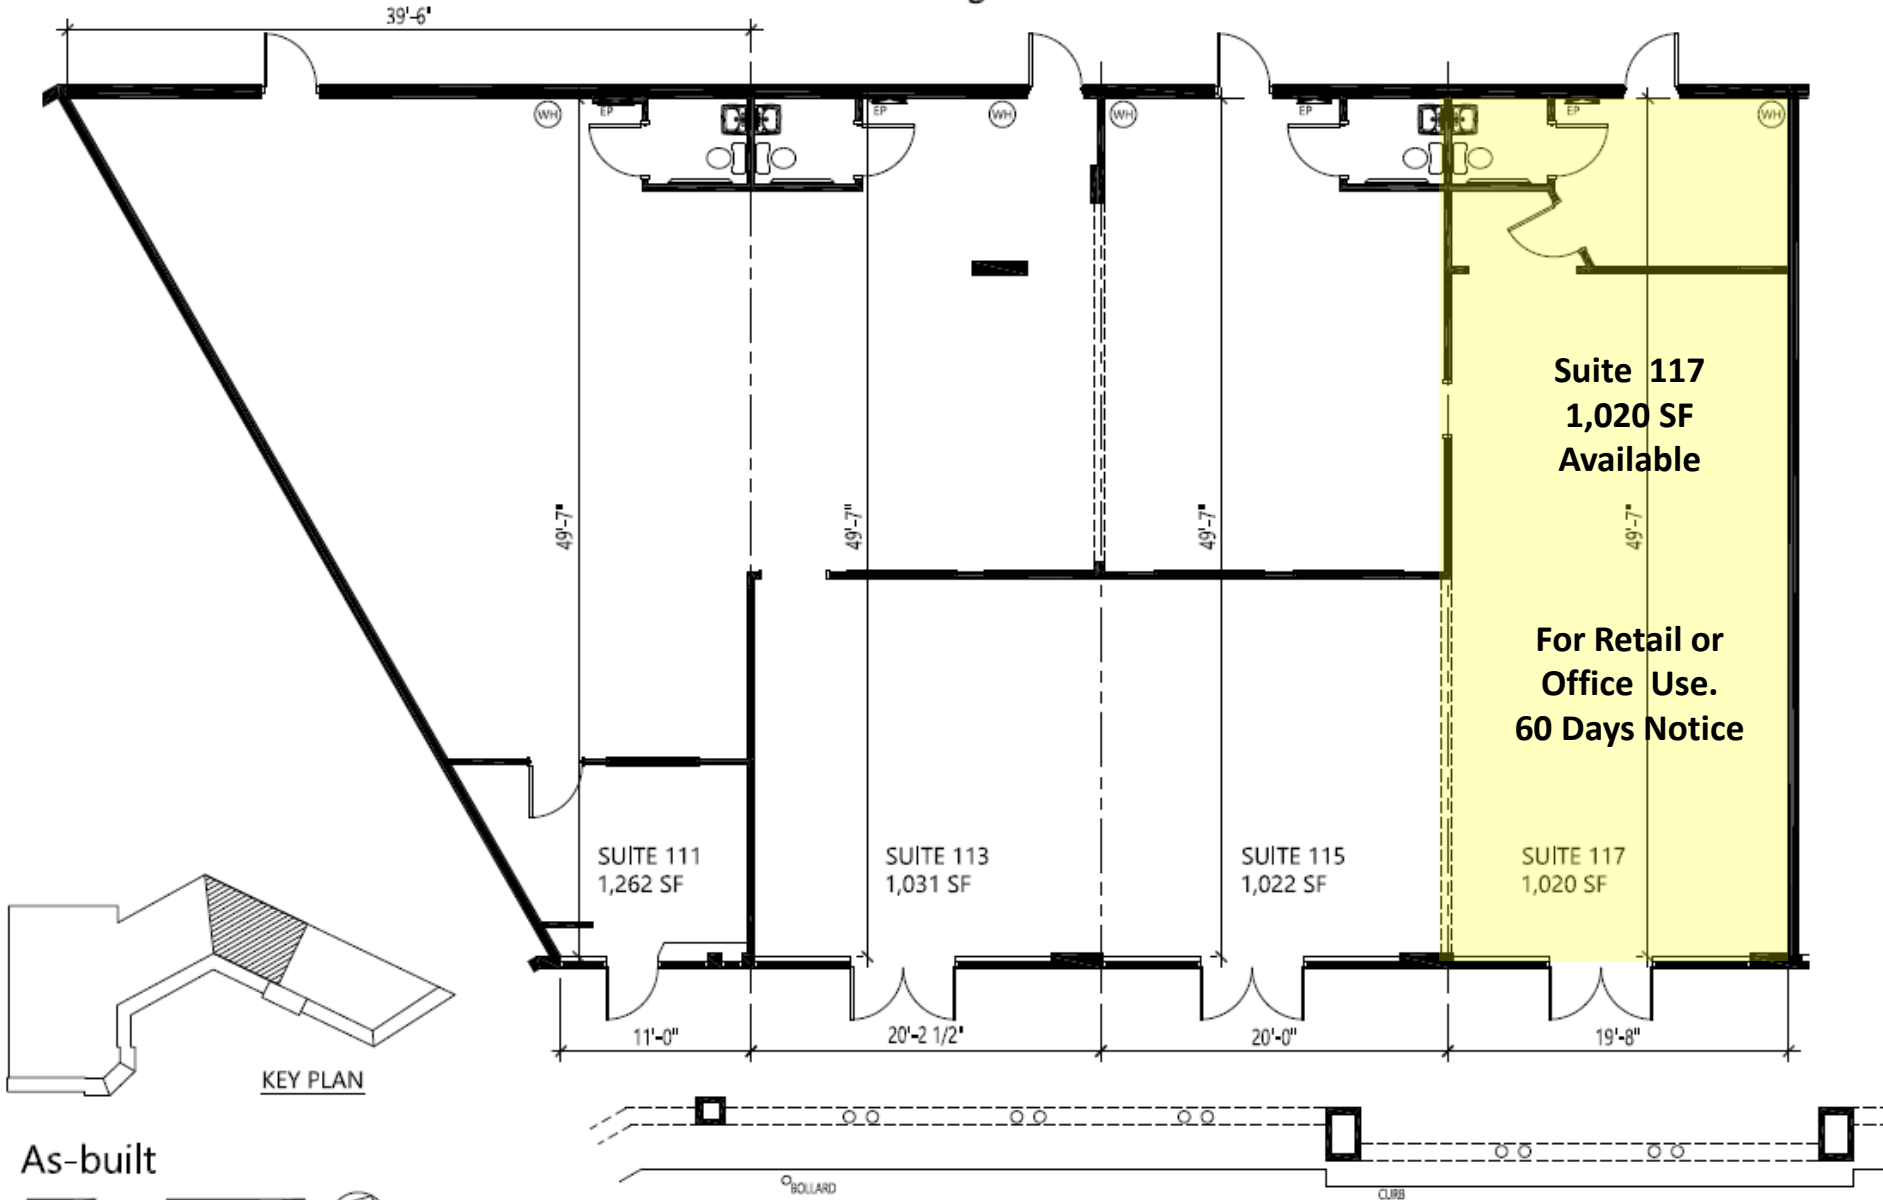

As-built
0 4' 8' 16'
TOTAL - 4,335 RSF
1/27/2021