



4961 Lower Roswell Road  
Marietta, Georgia 30068

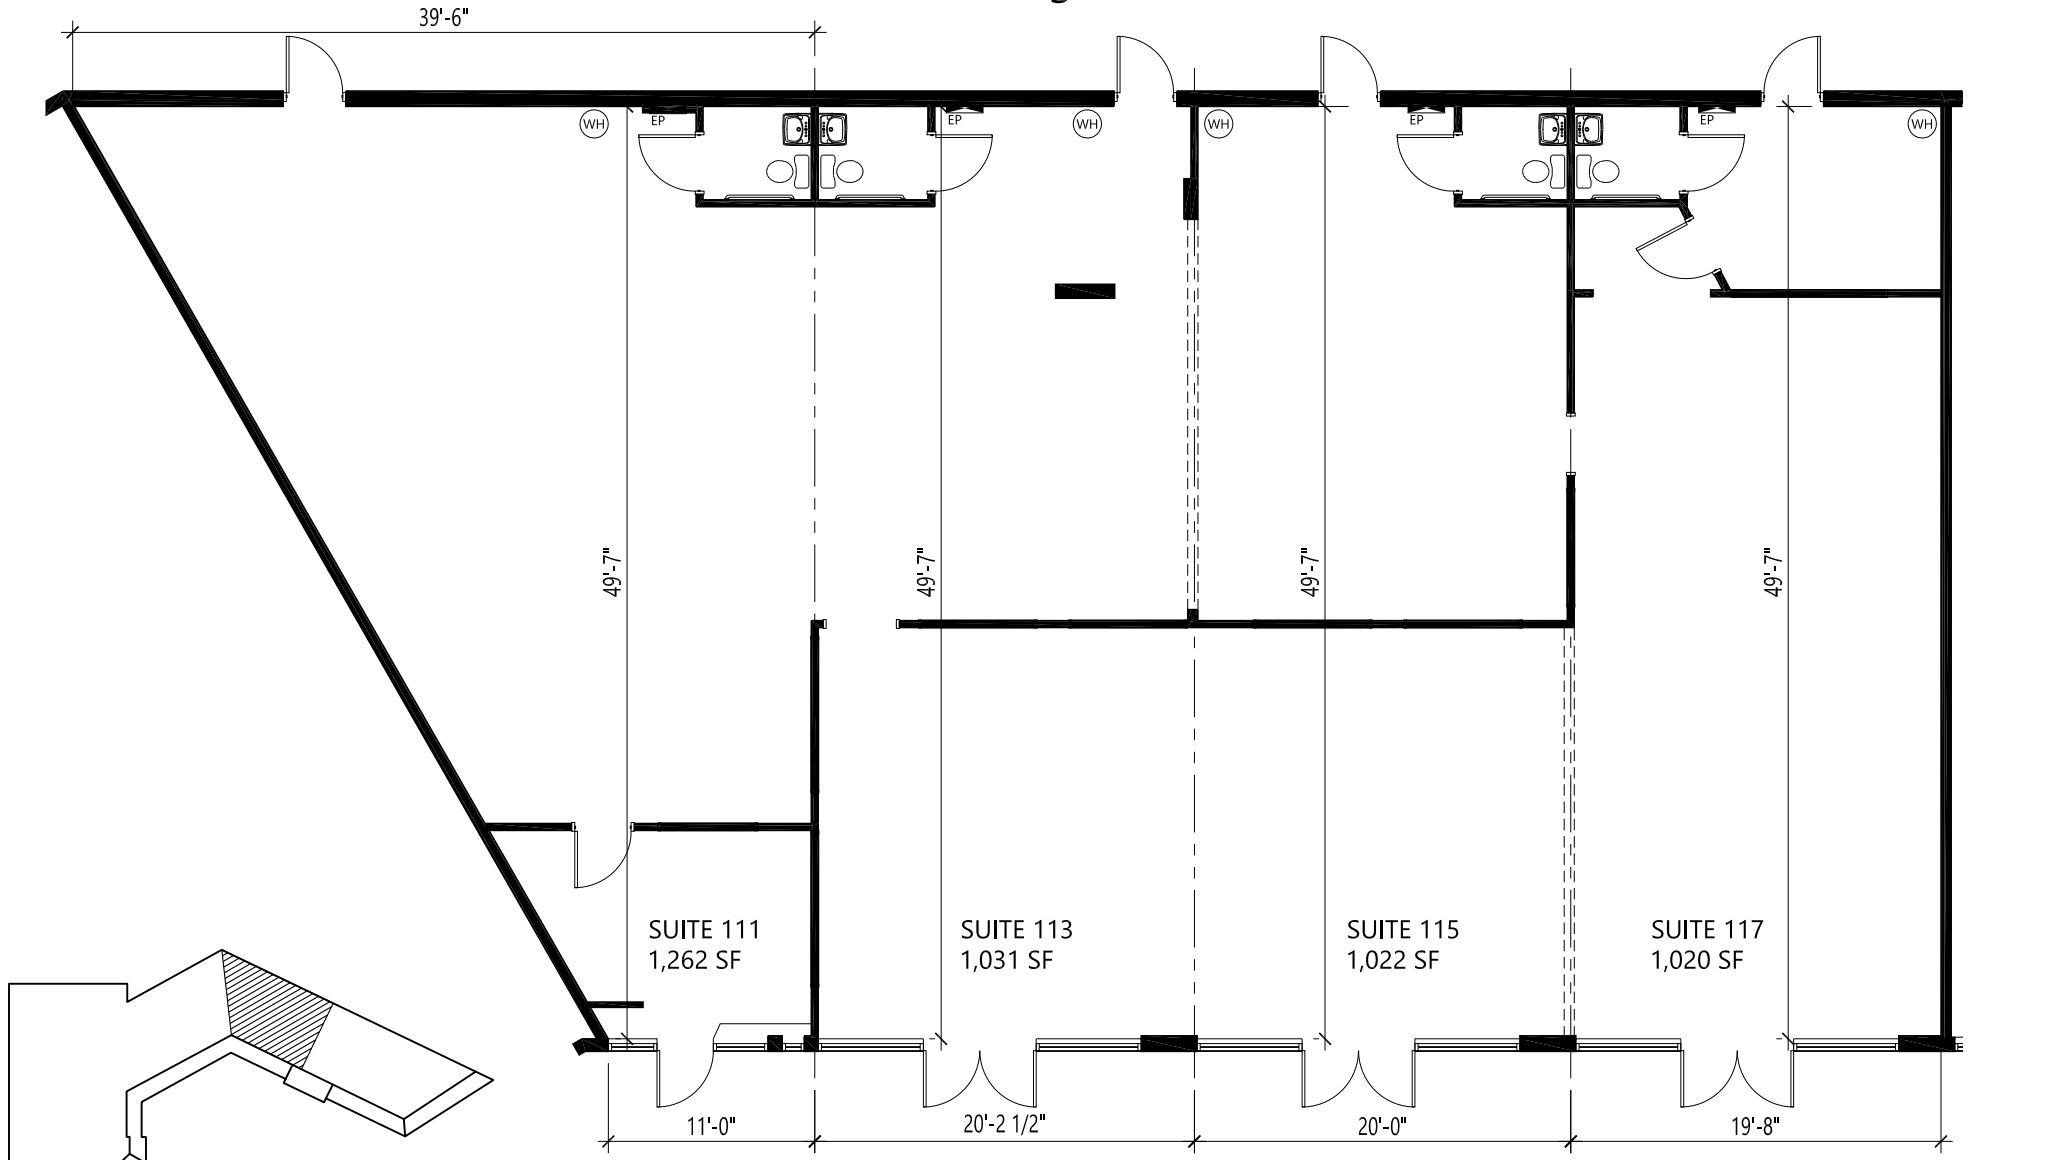

As-built

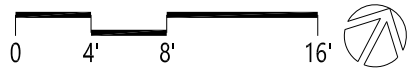

TOTAL - 4,335 RSF  
1/27/2021

