



NOTE:
1. THE EXTERIOR FACADE STRUCTURE WAS NOT MEASURED OR IN THE SCOPE OF THE WORK PERFORMED.
2. THE INTERIOR EXISTING LAYOUT WAS THE ONLY AREA FIELD VERIFIED FOR AS-BUILT.
3. ALL WALLS ARE LOCATED TO 4'-1" EXISTING TURNING POINT. WILL SHOW MEASUREMENTS. SOME WALLS ARE NOT SQUARE.

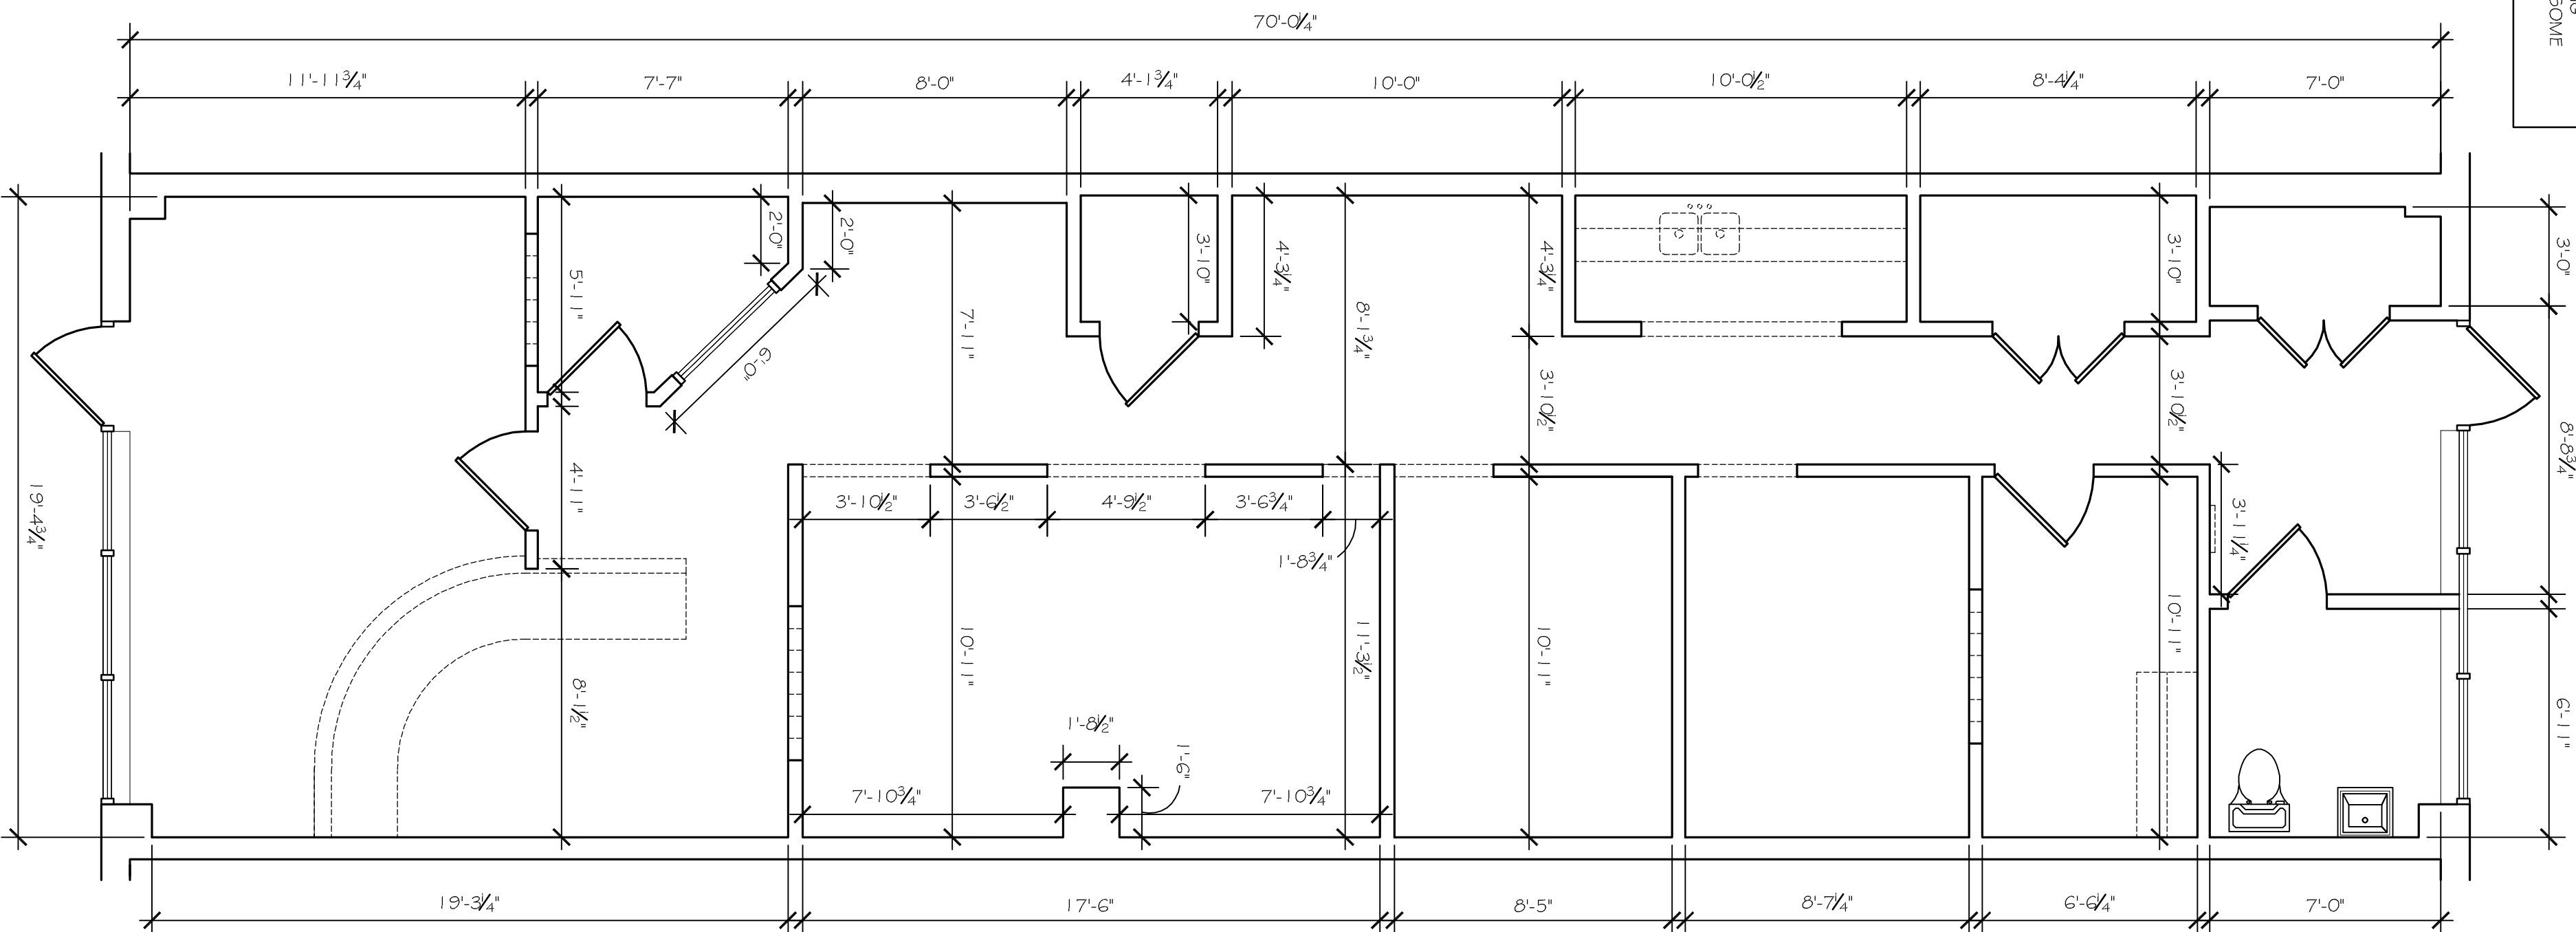

Dimension Plan

SCALE: 1/4" = 1'-0"

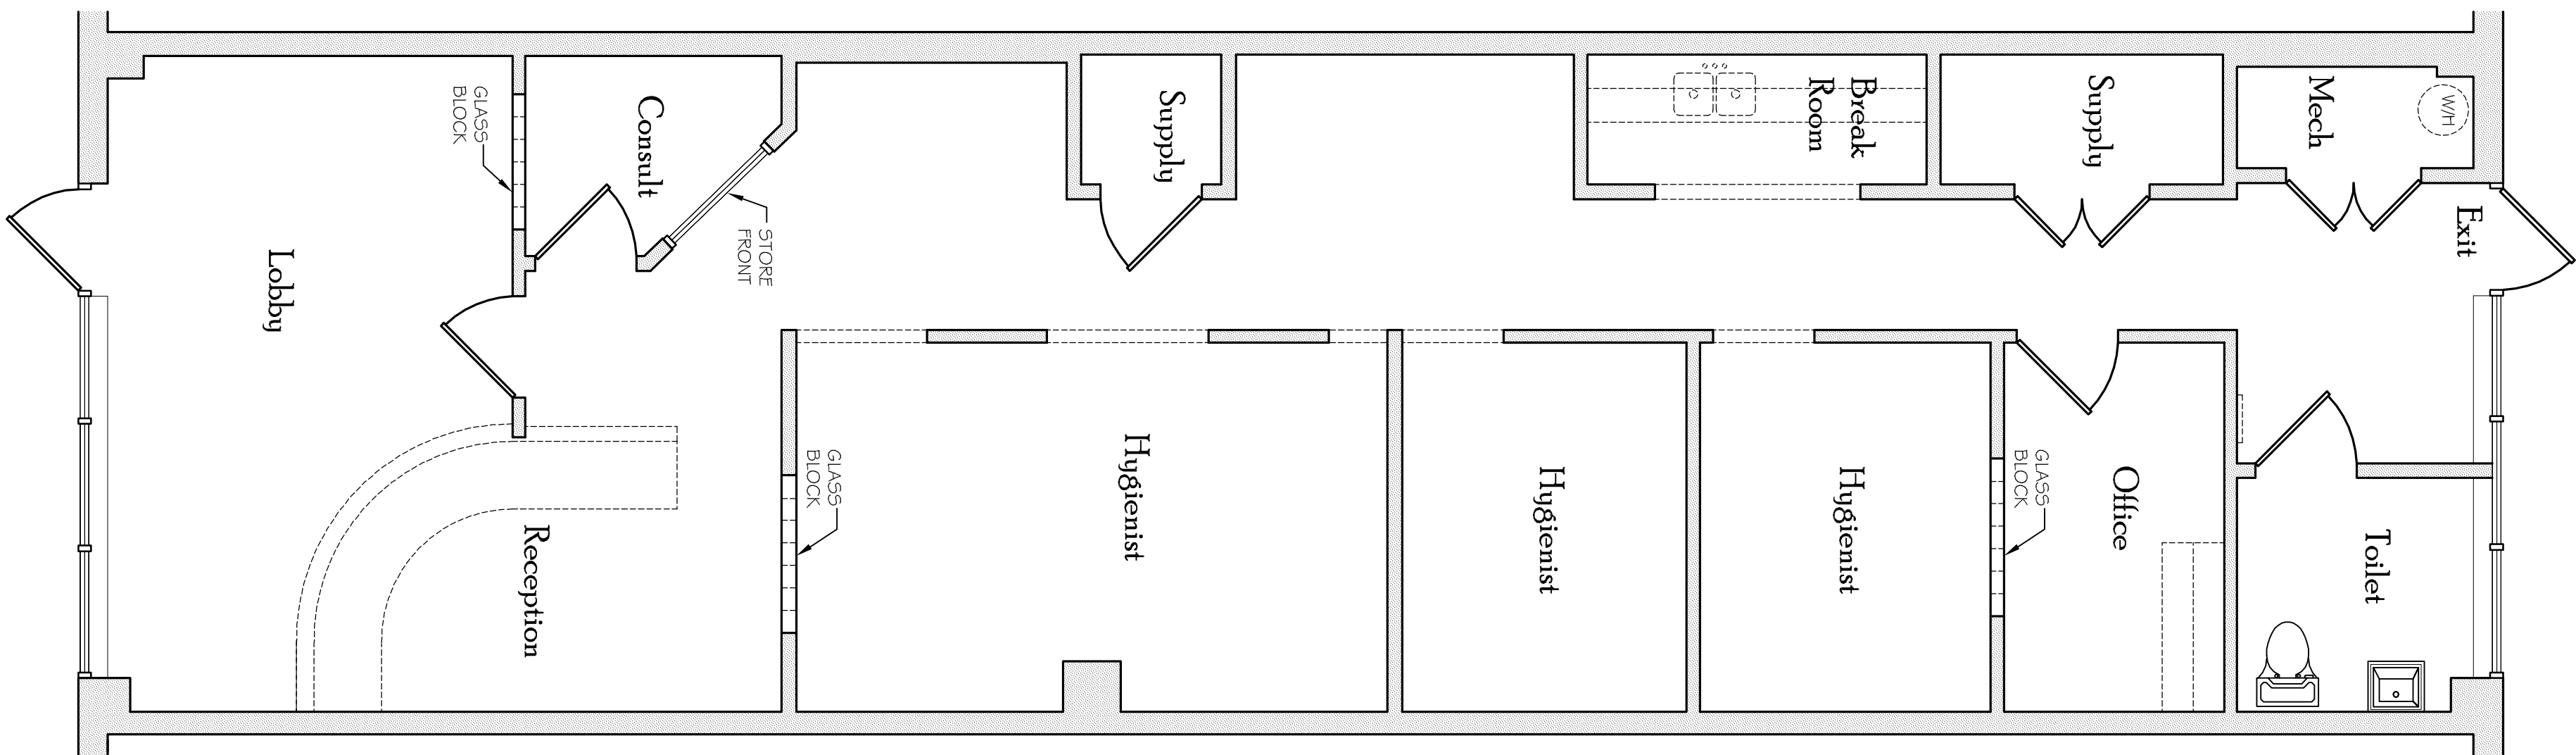

Floor Plan

SCALE: 1/4" = 1'-0"

COLUMBUS PARK CROSSING - AS-BUILT -

2501 Whittlesey Blvd, Suite 6 - 1,453sf
COLUMBUS, GEORGIA

14 APRIL 2025

A11
AS-BUILT
FLOOR PLAN,
DIM. PLAN