


# Park Summit

2675 Breckinridge Boulevard, Duluth, GA 30096



Key Plan

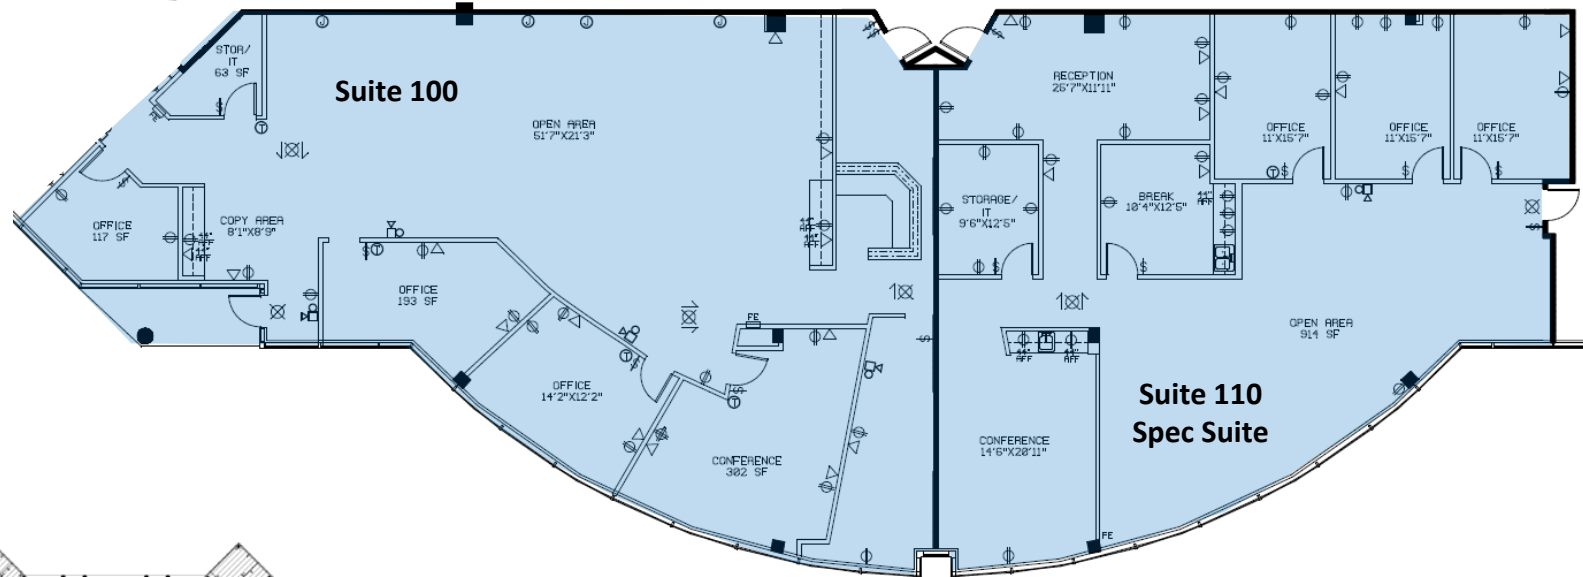

Suite 100	3,858 SF
Suite 110	3,246 SF (Spec Suite)
Combined	7,104 SF

Candy McIntyre  
Vice President, Leasing  
Direct: 770.623.2099  
Mobile: 404.408.9788  
[cmcintyre@BrandProperties.com](mailto:cmcintyre@BrandProperties.com)

**BRAND** Real Estate Services  
1960 Satellite Boulevard, Suite 1300  
Duluth, Georgia 30097  
770.476.4801 BrandProperties.com