


Magnolia Plaza – Suite 160 1,392 SF

3947 Gulf Shores Parkway, Gulf Shores, AL 36542

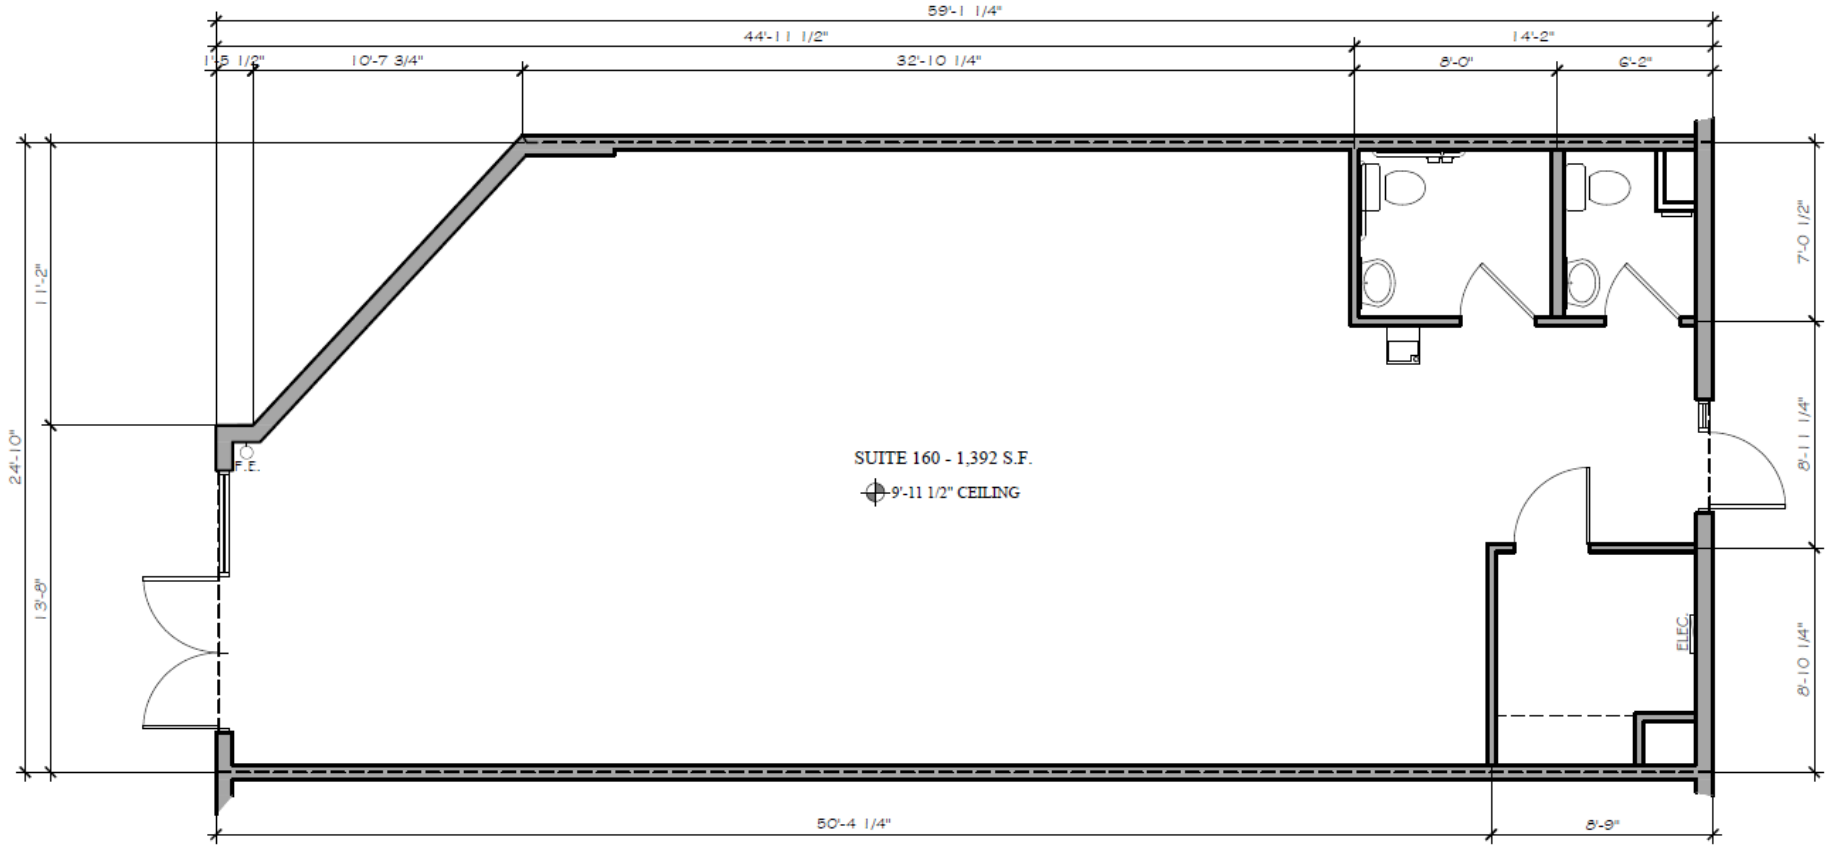

AS-BUILT
FLOOR PLAN
SCALE: 1/4"=1'-0"

