


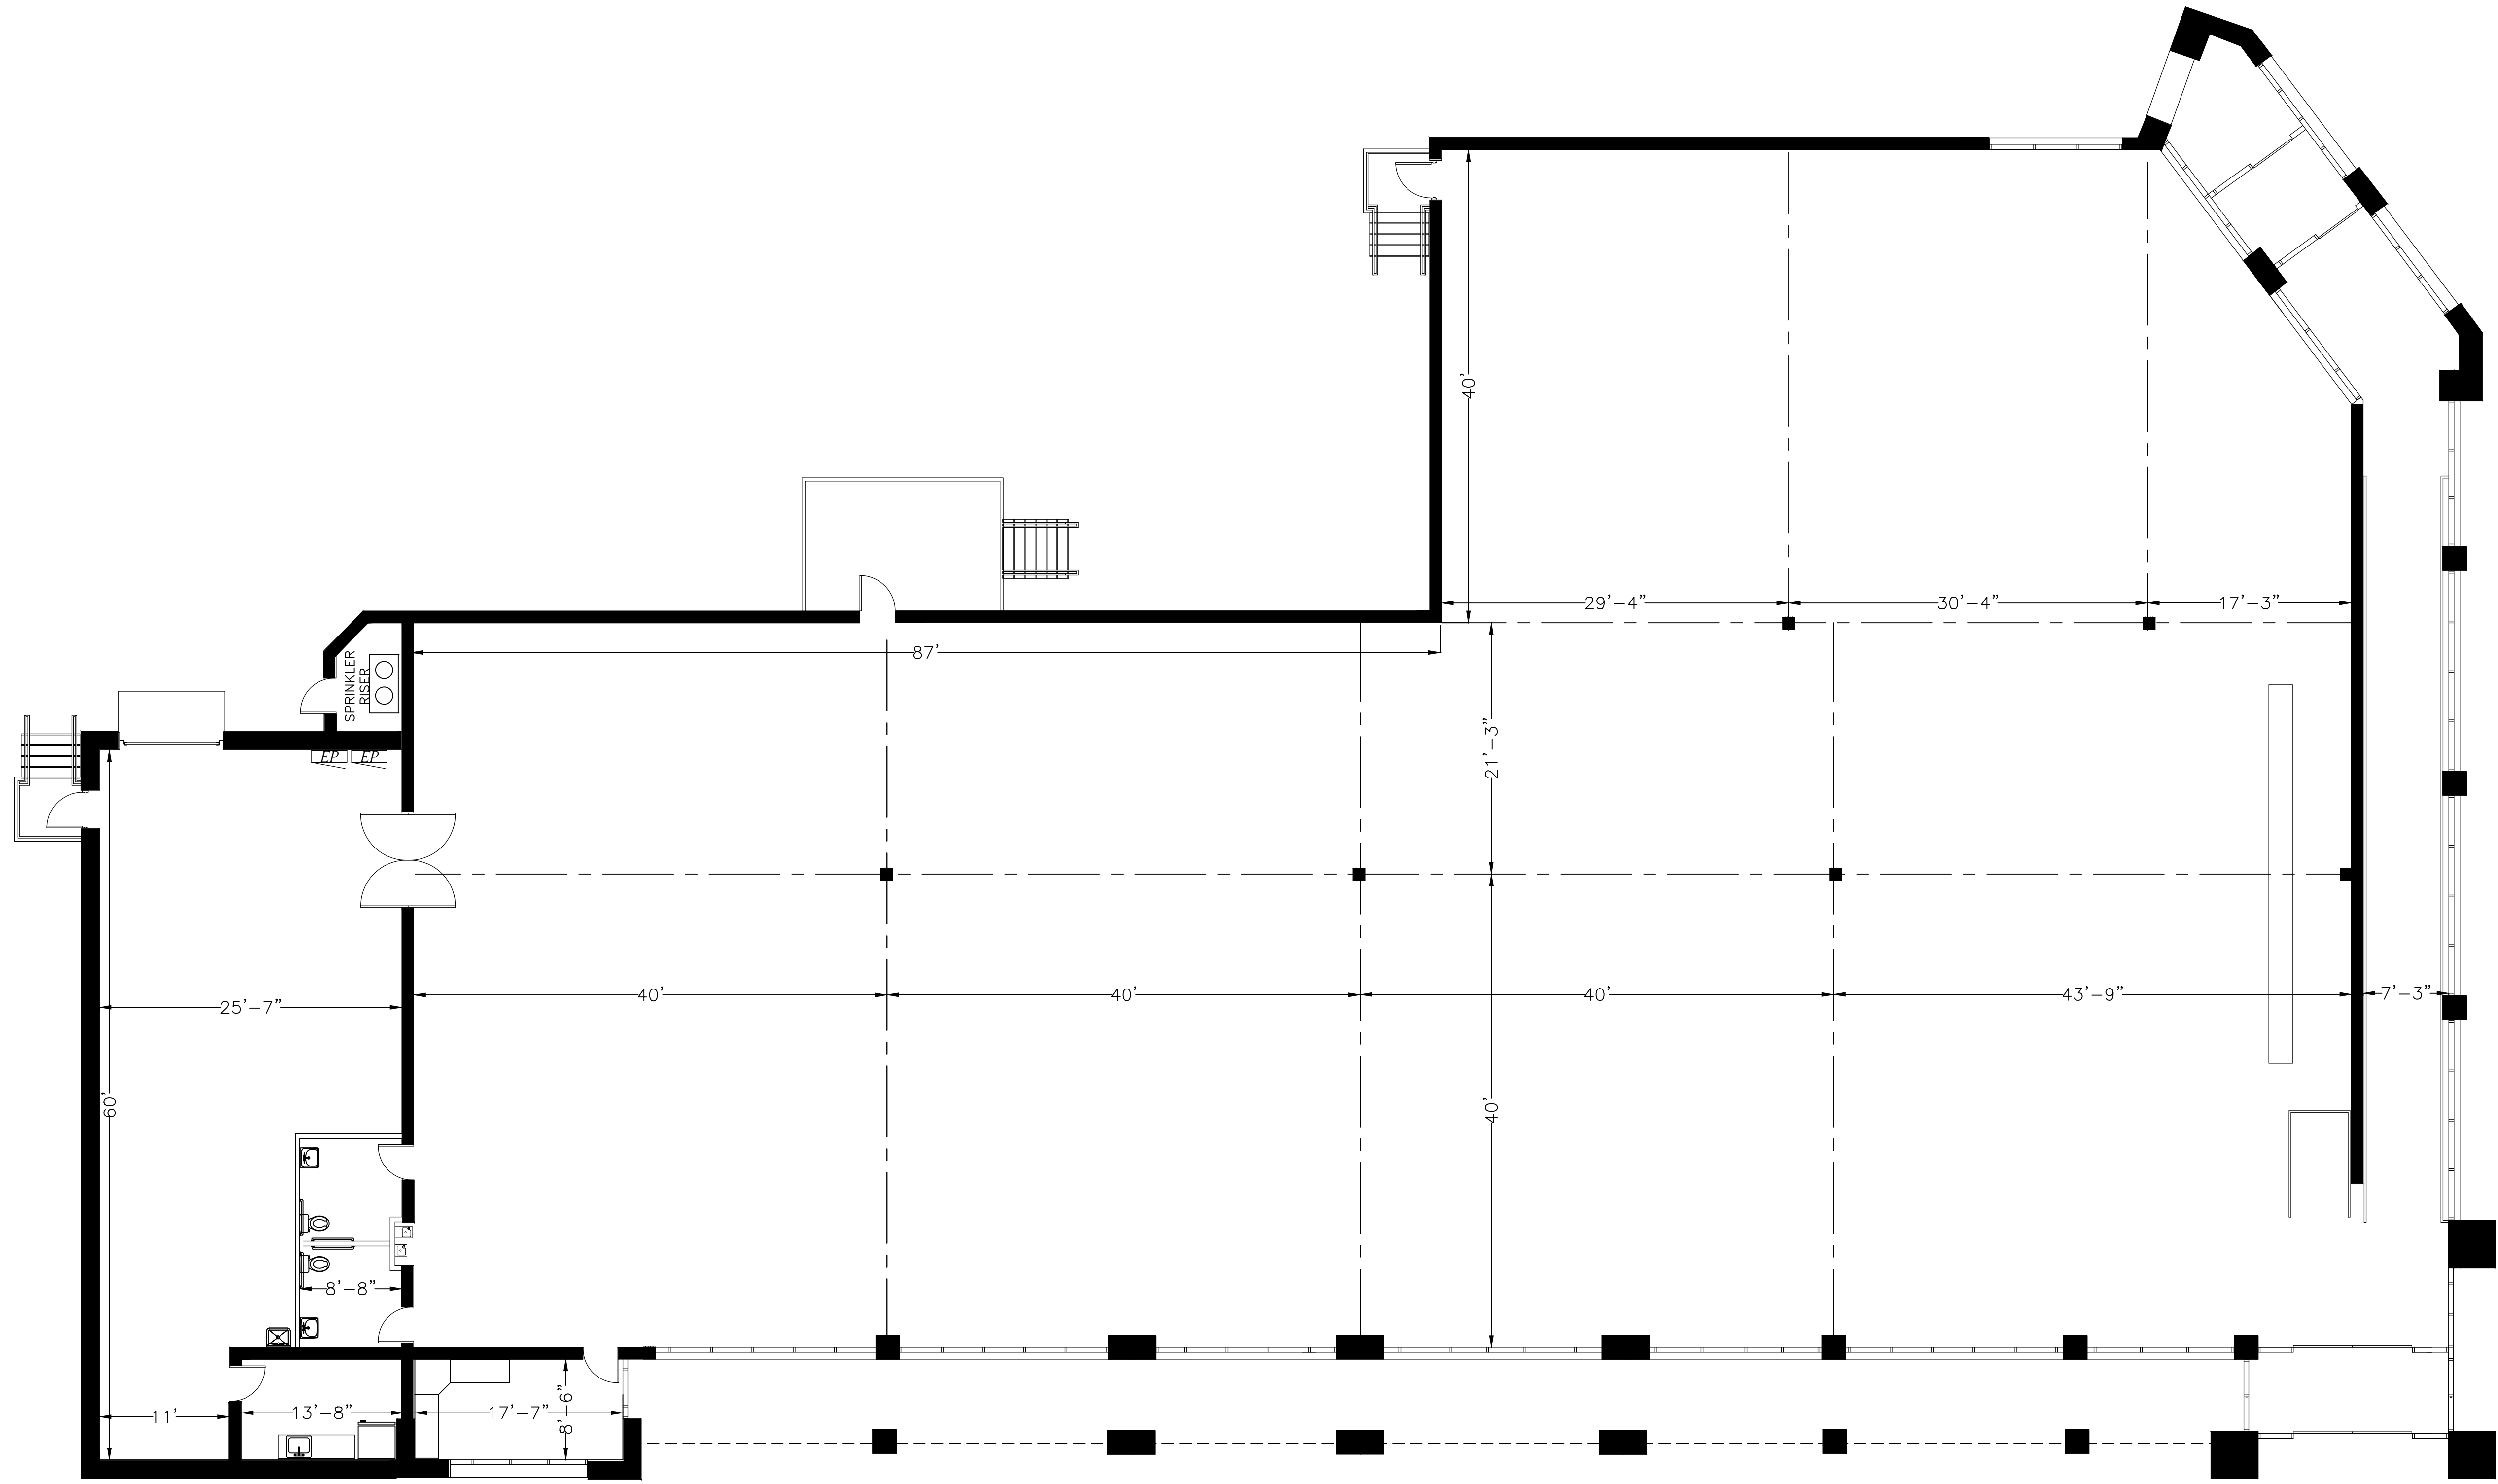

VACANT SPACE
1430 TOWNE LAKE PARKWAY
WOODSTOCK, GA

CATTER DESIGN GROUP
COMMERCIAL SPACE PLANNING, INTERIOR DESIGN,
AND CONSTRUCTION DRAWINGS

1000 Peachtree Industrial Blvd | Suite 6- 296 Suwanee, GA 30024
☎ 770-623-3019 X 1000 ☐ 770-316-6942
www.catterdesigngroup.com

REVISIONS	
SQUARE FOOTAGES:	
14,329 RETAIL AREA	
1,396 WAREHOUSE	
15,725 TOTAL	
SCALE:	1/8"=1'-0"
DRAWN BY:	SCN
PROJECT#	23116.00
DATE:	05-15-23
SHEET: 1	

ID-1

OF: 1